

**ATTACHMENT J.5 SAMPLE PEPCO**  
**AS-BUILT DRAWINGS**

SAMPLE PEPCO AS-BUILT DRAWINGS (3 Pages)

---

COLUMBIA ROAD NW  
800' EAST OF GA. AVE.  
50' (10', 30', 10')

COLUMBIA ROAD NW

"A" MATCH LINE "A"  
SEE SHEET 2

5TH STREET NW

HOBART PLACE NW  
40' (5', 30', 5')

P1  
781386-084527  
PROP' 8' X 12'  
ENTER 37' ROW EAST & WEST  
WALLS CENTERLINE & 48'D

HARVARD STREET NW

GRESHAM PLACE NW

SHEET 1 OF 3

P1  
781386-081131  
24" CS 84" DC  
24" CS 78" DC  
(EN-LARGE M.H. TO 6' X 12')  
HOLD NORTH, EAST & WEST  
WALLS EXTEND 4' SOUTH

STREET CAR TRACKS  
SHOULD HAVE BEEN REMOVED  
ON EXISTING ROAD PROJECT.

90' (24', 54', 12')  
GEORGIA AVE. NW

P4  
781386-155589  
PROP' 8' X 12'  
ENTER 37' ROW EAST & WEST  
WALLS CENTERLINE & 48'D

HOBART PLACE NW  
50' (13', 24', 13')

P2  
781386-082006  
EXISTING 8' X 12'  
24" CS 84" DC  
ENTER 37' ROW NORTH WALL  
CENTERLINE & 48'D

90' (24', 56', 10')  
GEORGIA AVE. NW

HARVARD STREET NW

GRESHAM PLACE NW

GIRARD STREET NW  
60' (15', 30', 15')

NOTES  
1-1

COLUMBIA ROAD NW  
800' EAST OF GA. AVE.  
50' (10', 30', 10')

P8  
784380-27630  
PROP. 6' X 12'  
ENTER OF VNW EAST & WEST  
WALLS CENTER LINE @ 40'D

WADDER STREET NW

MICHIGAN AVE. NW  
90' (38', 40', 12')

A MATCH LINE "A"  
SEE SHEET 1

P10  
784380-23018  
PROP. 6' X 12'  
ENTER OF VNW EAST & WEST  
WALLS CENTER LINE @ 30'D

784380-23018  
EX. 6' X 10'

PIPE WITH CAUTION EXACT  
LOCATION OF WATER UNKNOWN

P12  
785380-23042  
PROP. 6' X 12'  
ENTER OF VNW EAST & WEST  
WALLS CENTER LINE @ 30'D  
ENTER 5' VNW EAST WALL  
12' OFF THE NORTH WALL @ 30'D

SHEET 2 OF 3

McMILLAN PARK RESERVOIR


#111 CHILDREN'S HOSPITAL

MICHIGAN AVE. NW

P15  
785380-26738  
EX. 6' X 12'  
ENTER OF VNW WEST  
WALL CENTER LINE @ 30'D

B MATCH LINE "B"  
SEE SHEET 3

RESURFACING  
SPUR & JAW BAY  
CONCRETE BY NEW S&B  
ANNOUNCED

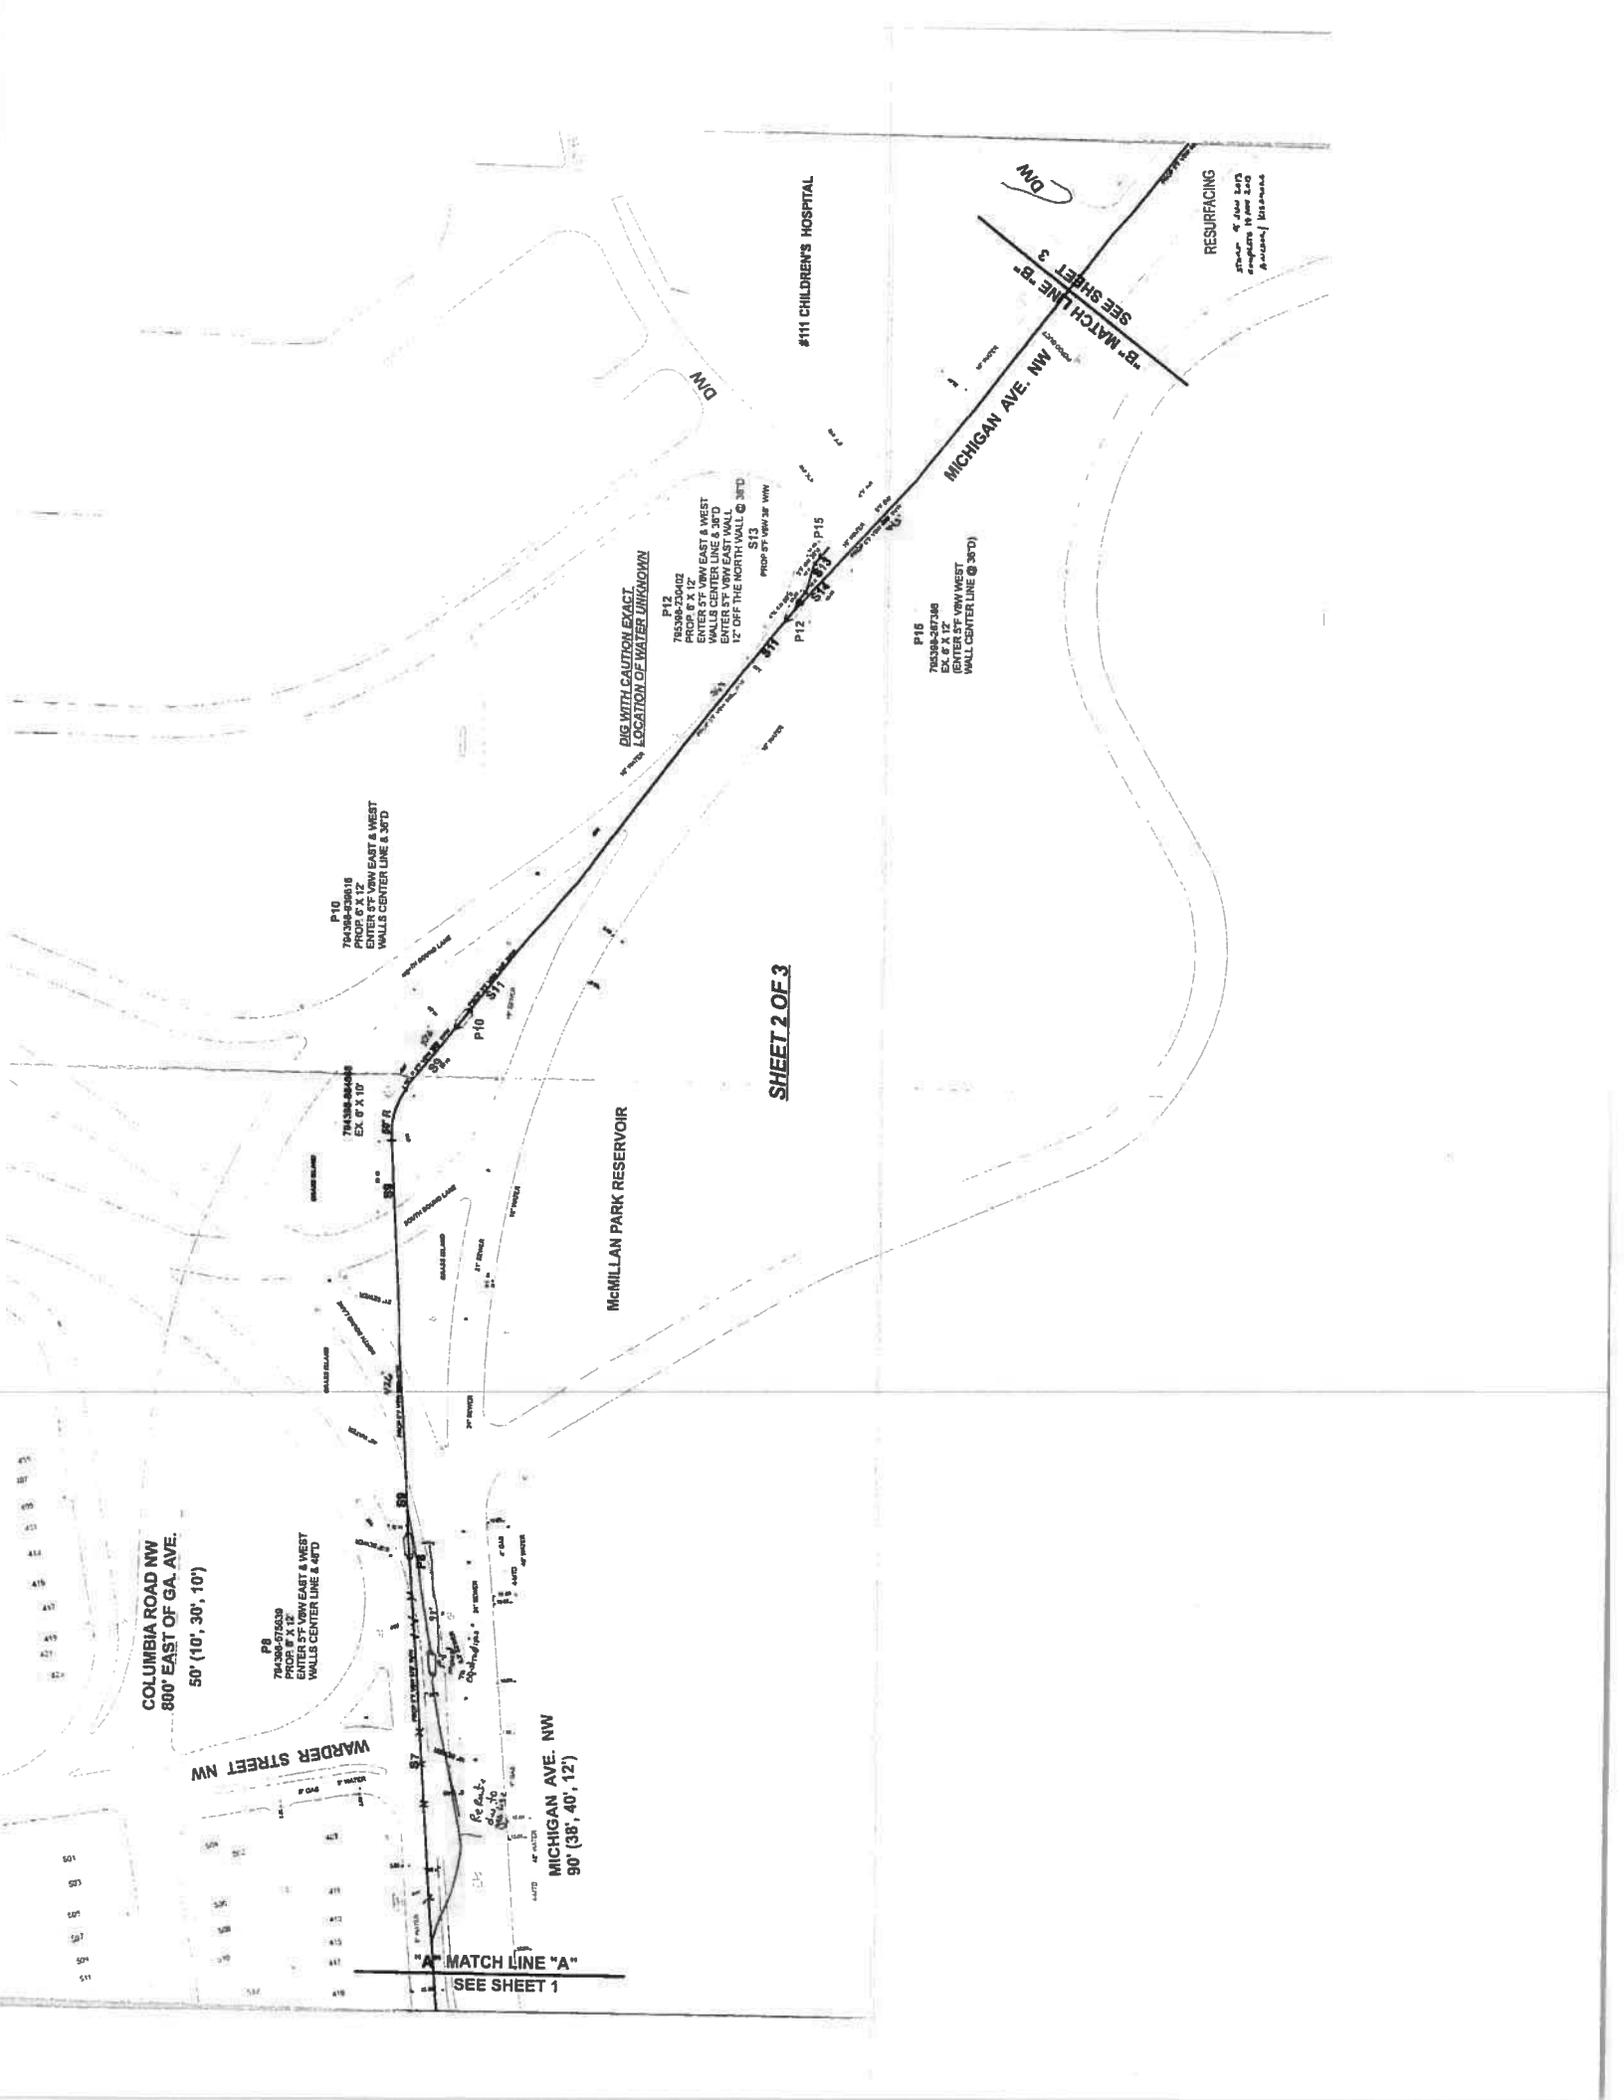

RESURFACING  
 1/2" = 10'-0"  
 1/4" = 5'-0"  
 1/8" = 2'-6"  
 1/16" = 1'-3"

WASHINGTON HOSPITAL CENTER

MICHIGAN AVE. NW

1st STREET NW

McMILLAN PARK RESERVOIR

SHEET 3 OF 3

DIG WITH CAUTION/ EXACT  
 LOCATION OF WATER MAIN

EX BAND FILTER  
 FILTRATION

P20  
 786388-130004  
 ENTER 5' VMM EAST & WEST  
 WALLS CENTER LINE & 30'D  
 WEST CORNER @ 30'D

P4/B  
 786387-078986  
 ENTER 5' VMM EAST & WEST  
 WALLS CENTER LINE & 30'D

P18  
 786388-02118  
 ENTER 5' VMM EAST & WEST  
 WALLS CENTER LINE & 30'D

786388-08110  
 EX 8' X 12'

B" MATCH LINE "B"  
 SEE SHEET 2

